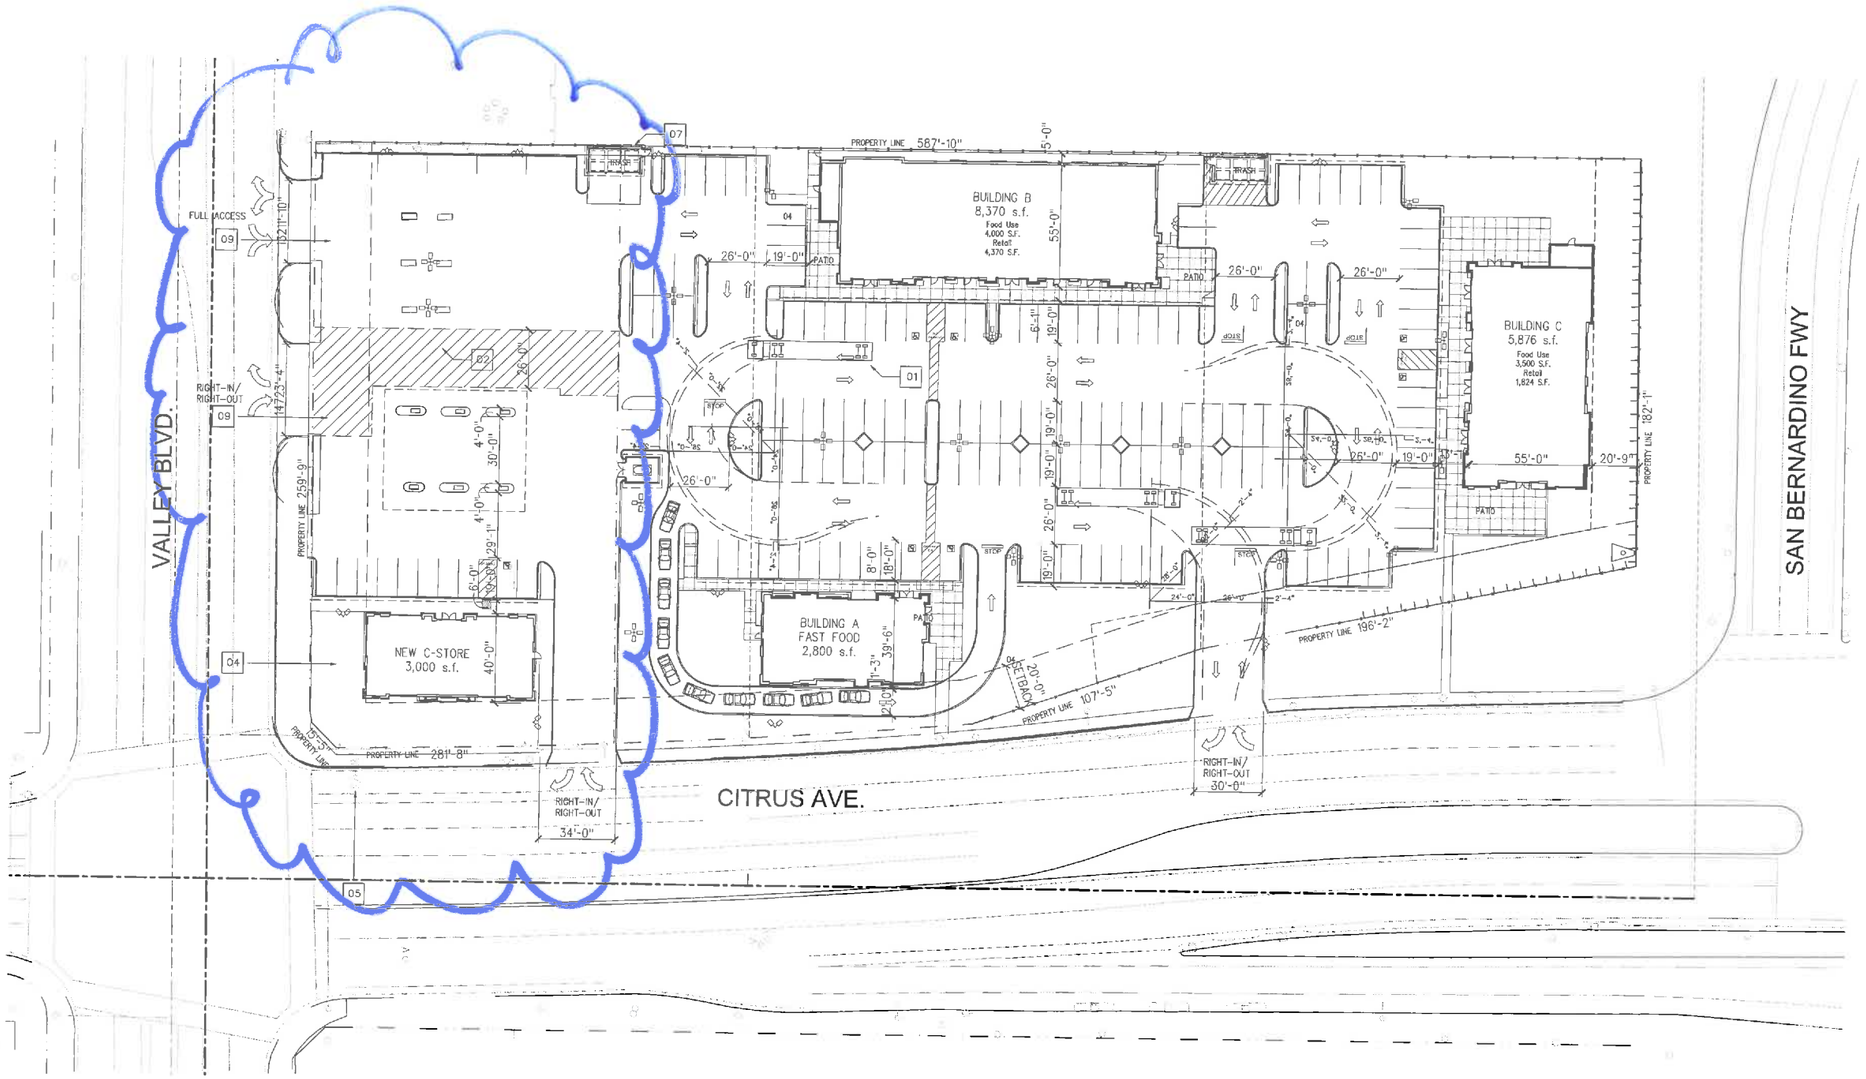

SYMBOL
01 NUMBER

NO.	DESCRIPTION
01	TRUCK TURNING RADIUS
02	PROPOSED 26' RECIPROCAL PARKING AND ACCESS EASEMENT

1"=30'-0" 0 15' 30' 60' 90'

C-Store / Gas Station
Approved
Dec 1, 2016

BUNDY-FINKEL • Architects
1120 • BRISTOL STREET • STE 120
COSTA MESA • CA 92626
TEL 714 • 850 • 7575
FAX 714 • 850 • 7576

PROJECT NAME:

CITRUS-VALLEY CENTER

Citrus Ave.
Fontana, CA

SHEET TITLE

SITE CIRCULATION PLAN

NOTICE: THE DESIGNS SHOWN AND DESCRIBED HEREIN, INCLUDING ALL TECHNICAL DRAWINGS, GRAPHICS, AND MODELS THEREOF, ARE PROPRIETARY AND SHALL NOT BE COPIED, DUPLICATED, REUSED OR COMMERCIALLY EXPLOITED IN WHOLE OR IN PART, WITHOUT THE WRITTEN PERMISSION OF BUNDY-FINKEL. ALL PLANS AND DRAWINGS THESE DRAWINGS HAVE BEEN PREPARED TO DESCRIBE NEW WORK ONLY AND DO NOT REPRESENT AS-BUILT OR ACCURATELY EXISTING CONDITIONS. THE ARCHITECT DOES NOT WARRANT IN ANY WAY THE ACCURACY OF THIS INFORMATION AND SHALL NOT BE RESPONSIBLE FOR DISCREPANCIES BETWEEN THIS DOCUMENT AND EXISTING CONDITIONS. THESE PLANS ARE THE PROPERTY OF THE ARCHITECT AND ARE NOT TO BE USED IN WHOLE OR IN PART FOR ANY LOCATION BY THE CLIENT, CONSULTANTS, CONTRACTORS, CONTRACTOR'S LICENSEES, VENDORS, AND OFFICE PERSONNEL ONLY IN ACCORDANCE WITH WITH THE AGREEMENT. ADDITIONALLY, CONTRACTORS SHALL VERIFY DIMENSIONS AND SHALL NOT SCALE THE DRAWINGS AT ANY TIME.

ALL RIGHTS RESERVED © COPYRIGHT, BUNDY-FINKEL ARCHITECTS, 2016

PROJECT NO.: 14-628
LAST ISSUE DATE: 04-11-16
BY: CHKD: RF
CUP SUBMITTAL 04-11-16

FILE:

SHEET
A-2

VIEW FROM NORTHWEST

VIEW FROM SOUTHWEST

VIEW FROM NORTHEAST

VIEW FROM SOUTHEAST

BUNDY-FINKEL • Architects
1120 • BRISTOL STREET • STE 120
COSTA MESA • CA 92626
TEL 714 • 850 • 7575
FAX 714 • 850 • 7576

PROJECT NAME:

CITRUS-VALLEY CENTER

Citrus Ave.
Fontana, CA

SHEET TITLE

SITE 3D VIEWS

NOTICE: THE DESIGNS SHOWN AND DESCRIBED HEREIN, INCLUDING ALL TECHNICAL DRAWINGS, GRAPHICS, AND MODELS THEREOF, ARE PROPRIETARY AND SHALL NOT BE COPIED, DUPLICATED, RELISED, OR COMMERCIALLY EXPLOITED IN WHOLE OR IN PART, WITHOUT THE EXPRESS PERMISSION OF BUNDY/FINKEL ARCHITECTS. ADDENDUMS, THESE PLANS ARE INTENDED FOR USE ON THIS PROJECT AND SITE ONLY AND DO NOT REPRESENT AS-BUILT OR ACCURATE AS-CONSTRUCTION CONDITIONS. THE ARCHITECT DOES NOT WARRANT IN ANY WAY THE ACCURACY OF THIS INFORMATION AND SHALL NOT BE RESPONSIBLE FOR DISCREPANCIES BETWEEN THIS DOCUMENT AND EXISTING CONDITIONS. THESE PLANS ARE THE PROPERTY OF THE ARCHITECT AND ARE AVAILABLE FOR LIMITED REVIEW AND EVALUATION BY THE CLIENT, CONSULTANTS, AND GOVERNING AGENCIES, VENDORS, AND DEVICE PURCHASES ONLY IN CONFORMANCE WITH THIS NOTICE. ADDITIONALLY, CONTRACTORS SHALL VERIFY DIMENSIONS AND SHALL NOT SCALE THE DRAWINGS AT ANY TIME.

ALL RIGHTS RESERVED. © COPYRIGHT, BUNDY-FINKEL ARCHITECTS, 2016

PROJECT NO.: 14-628
LAST ISSUE DATE: 04-11-16
BY: CHKD: RF
CUP SUBMITTAL 04-11-16

FILE:

SHEET
A-9